

June 28, 2010

Ms. Tyree Mullaney
Regulatory Officer
Mackenzie Valley Land and Water Board
7th Floor - 4922 48th Street
PO BOX 2130
YELLOWKNIFE NT X1A 2P6

Dear Ms. Mullaney:

As-Built Drawing – Yellowknife Airport Glycol Retention and Treatment Facility

Attached is the as-built drawing of the new Glycol Retention and Treatment Facility (GRTF) located at the Yellowknife Airport.

Note that the coordinates of the monitoring wells are also included. Some locations have changed from those indicated by the Inspector in response to operational needs.

If you require further information please contact me at 873-4680 or by e-mail at steve_loutitt@gov.nt.ca.

Yours truly,



for Steve Loutitt
Regional Airport Manager
Yellowknife Airport

c. Ms. Rhonda Batchelor, Senior Environmental Analyst
DOT, GNWT


Mr. Michael Martin, Water Resources Officer
Indian and Northern Affairs Canada

Mr. Robert Jenkins, Water Resources Division
INAC

Mr. Michael Conway, Regional Superintendent
DOT, GNWT

UNIVERSAL TRANSVERSE MERCATOR COORDINATES
 ZONE 11, CENTRAL MERIDIAN 117° WEST (NAD83)

STATION	NORTHING	EASTING	ELEVATION
700	6928350.49	632701.36	204.76
701	6928303.46	632787.12	202.91
702	6928270.76	632720.46	202.95
703	6928316.84	632650.43	204.59

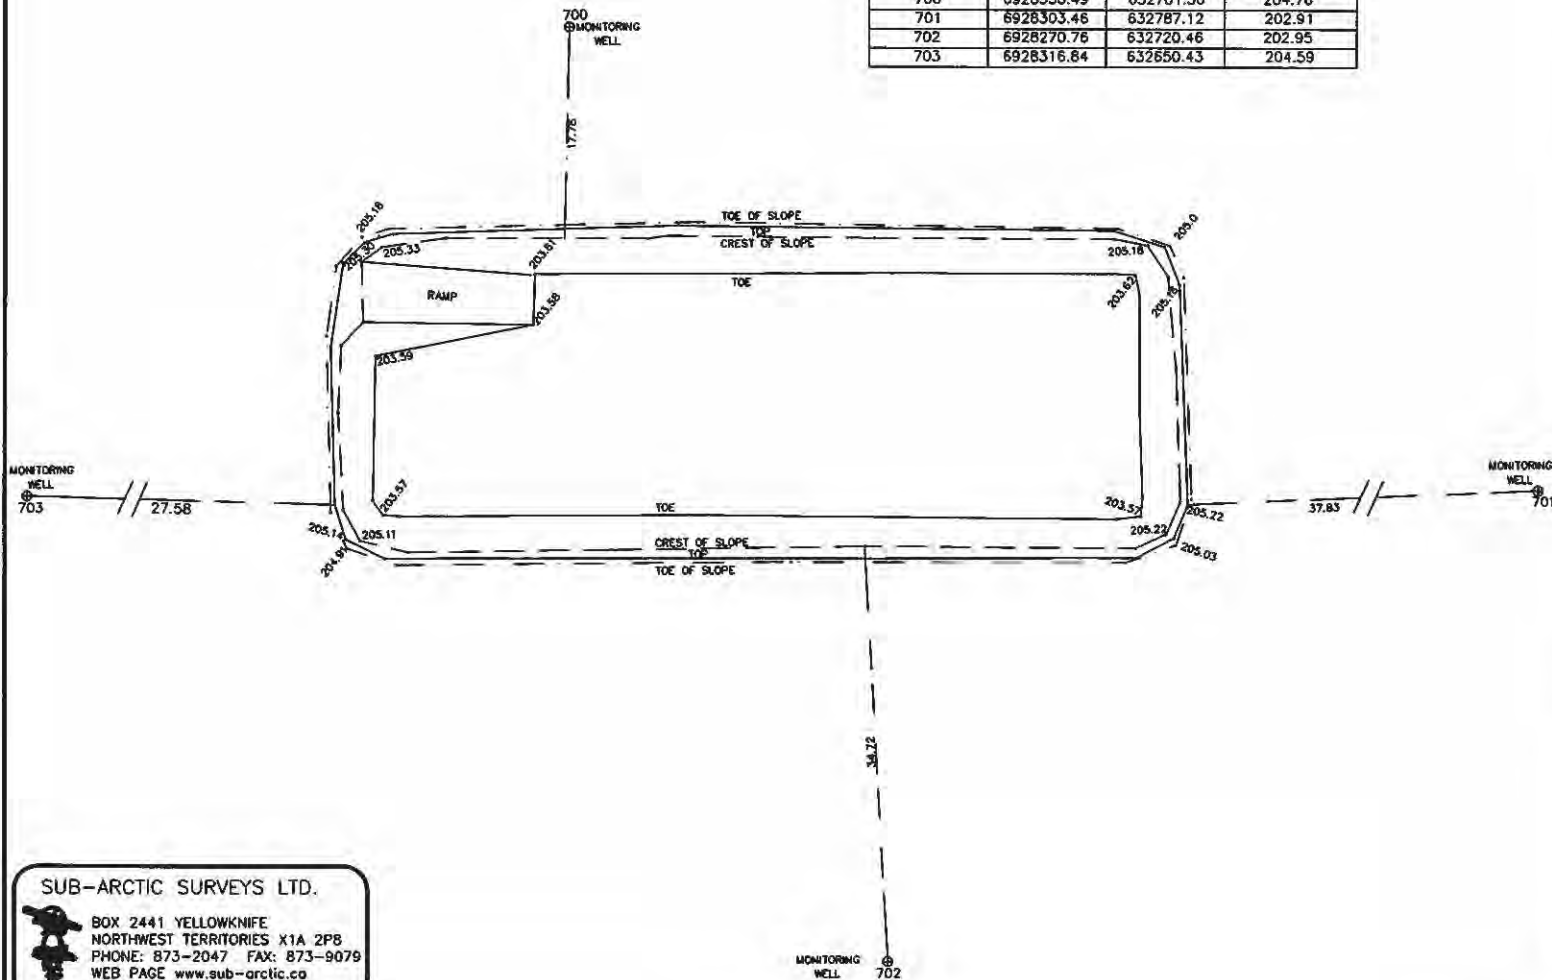

NOTES:
 DISTANCES AND ELEVATIONS ARE
 IN METRES AND DECIMALS.

ELEVATIONS ARE ORTHOMETRIC.

DATE OF SURVEY: June 17 2010

SURVEY REFERENCE POINT @
 SAS-TOWER:
 6927477.01 N
 635718.55 E
 ELEVATION = 245.52
 C.S.F. = 0.9997838

NO. REVISION/ISSUE DATE:

NO.	REVISION/ISSUE	DATE:

DRAWN BY: M.N.

CHECKED BY: G.T.

GOVERNMENT
 OF
 NORTHWEST TERRITORIES
 TRANSPORTATION DIVISION

AS BUILT SURVEY
 OF
 GLYCOL RETENTION FACILITY
 YELLOWKNIFE - N.T.

FILE NO.: 10-045-AD

DATE: JUNE 22, 2010

SCALE: 1:400

SUB-ARCTIC SURVEYS LTD.



BOX 2441 YELLOWKNIFE
 NORTHWEST TERRITORIES X1A 2P8
 PHONE: 873-2047 FAX: 873-9079
 WEB PAGE www.sub-arctic.ca
 E-MAIL sas@sub-arctic.ca