



SEWAGE LAGOON PROFILE

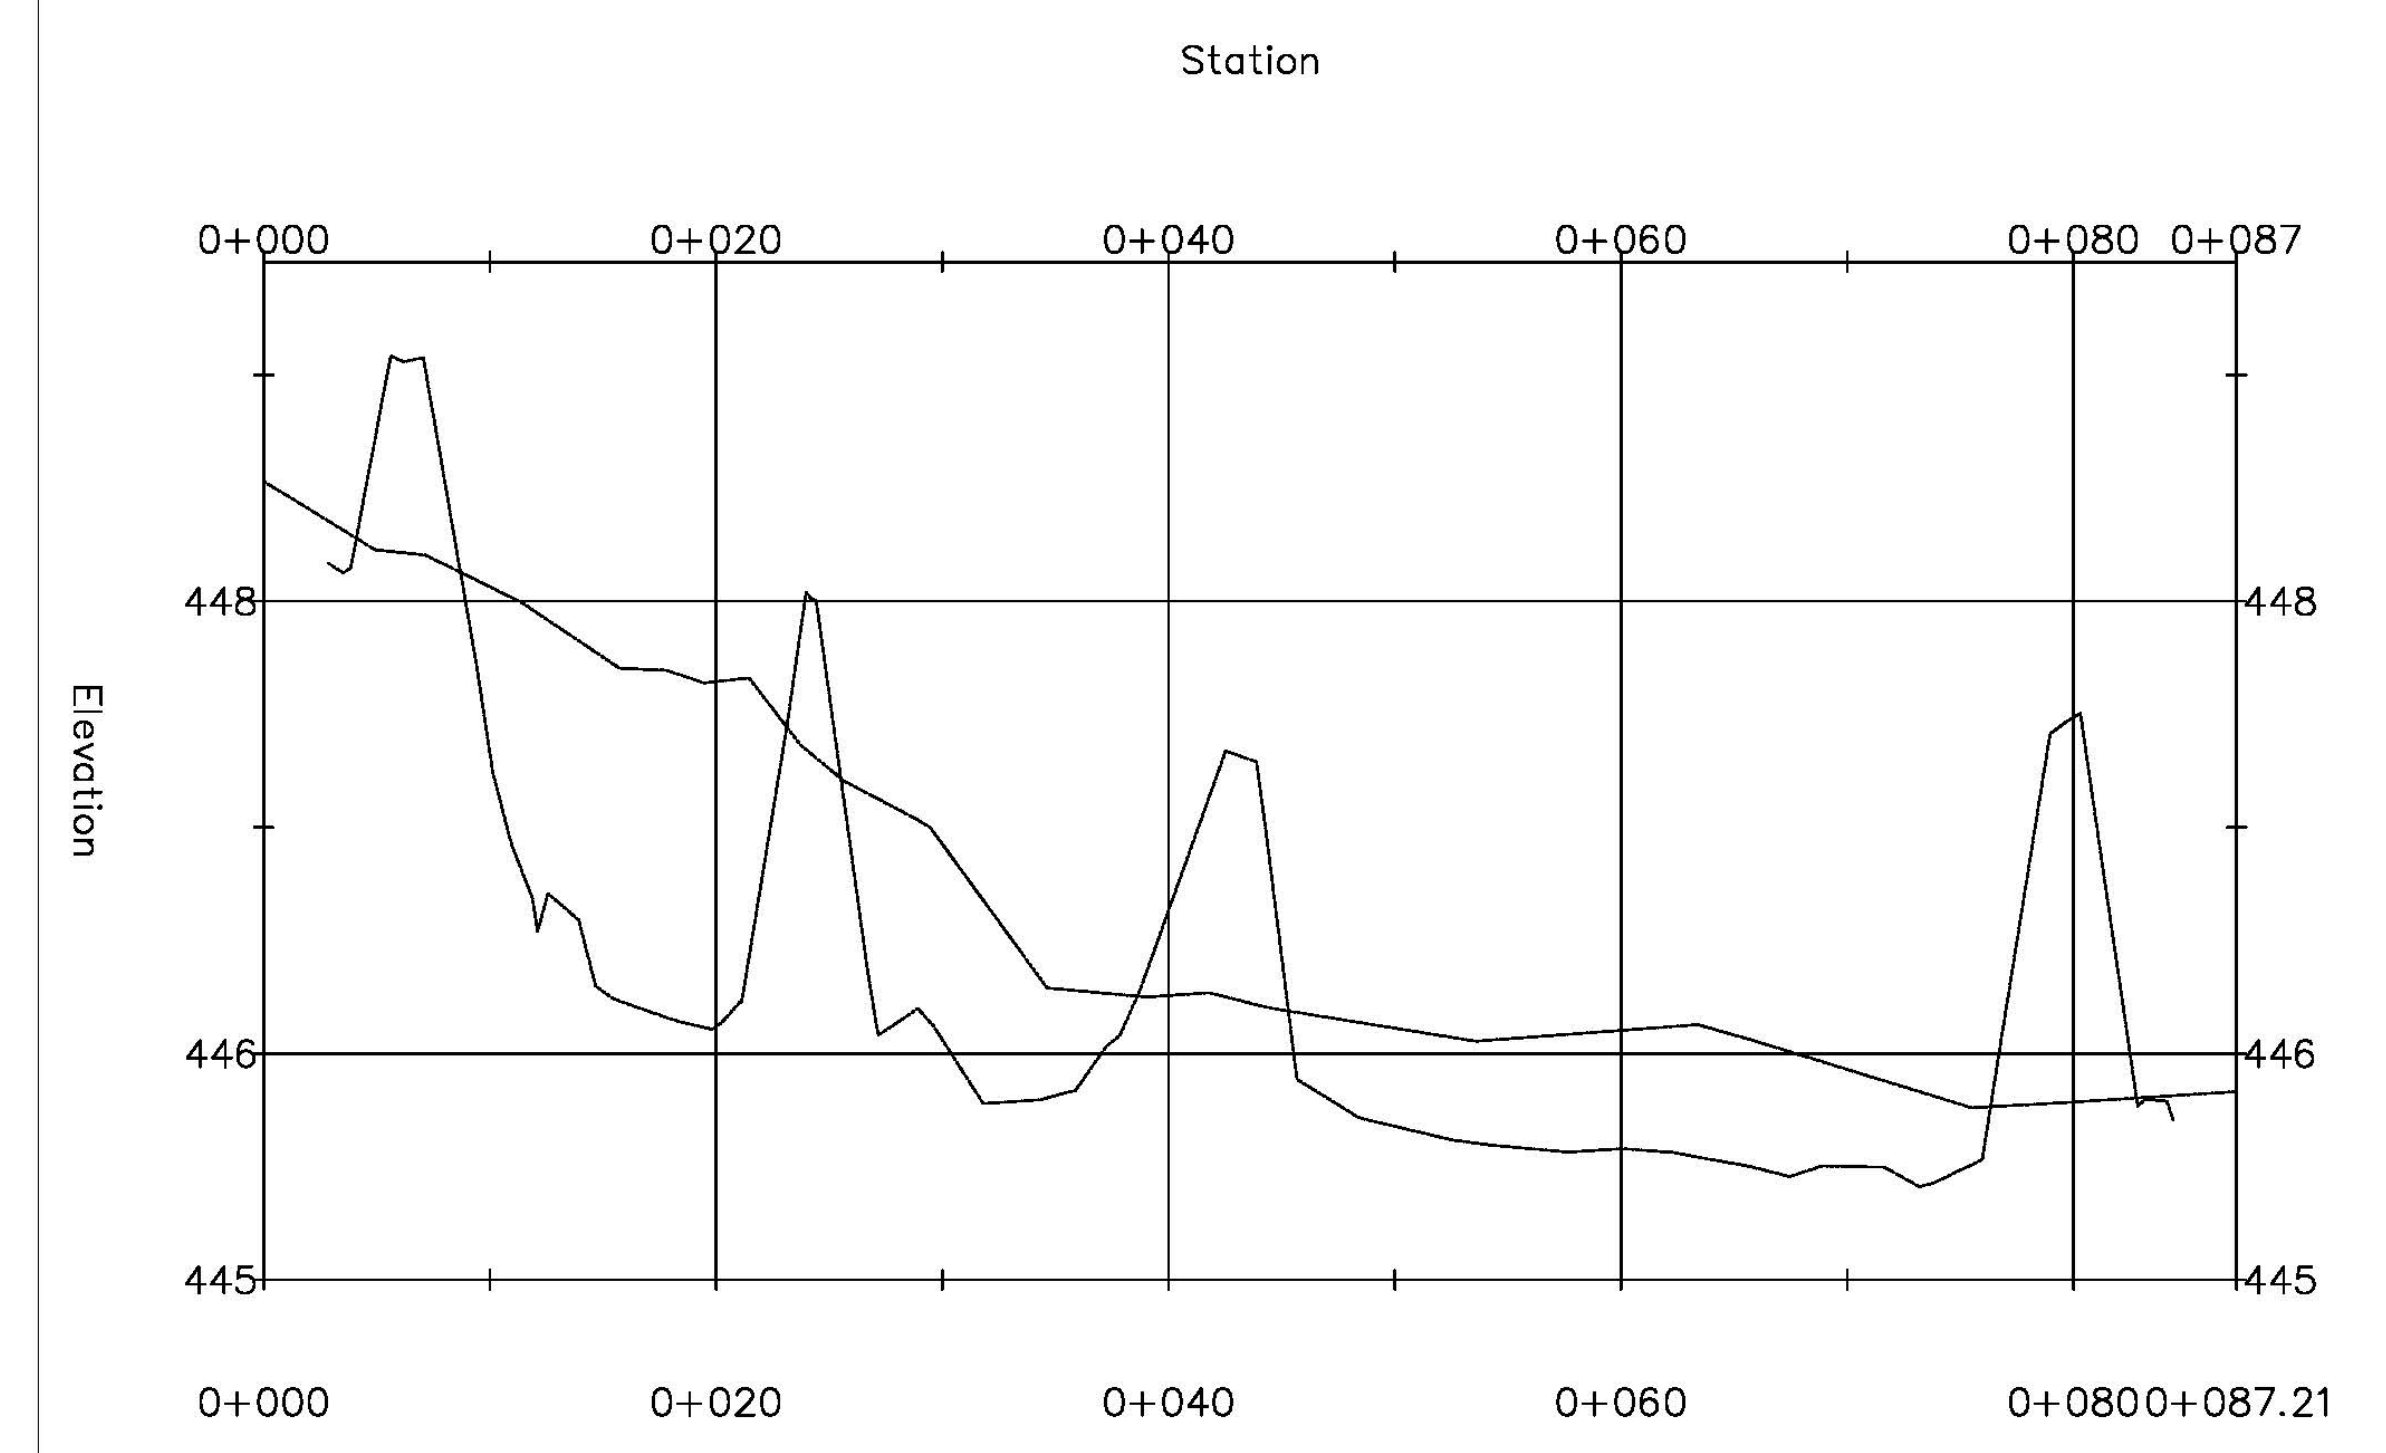

Index	Base Surface Existing Ground	Comparison Surface Sewage Lagoon	Cut	Fill	Net
1			331.79 Cu. M.	846.96 Cu. M.	515.17 Cu. M.<Fill>

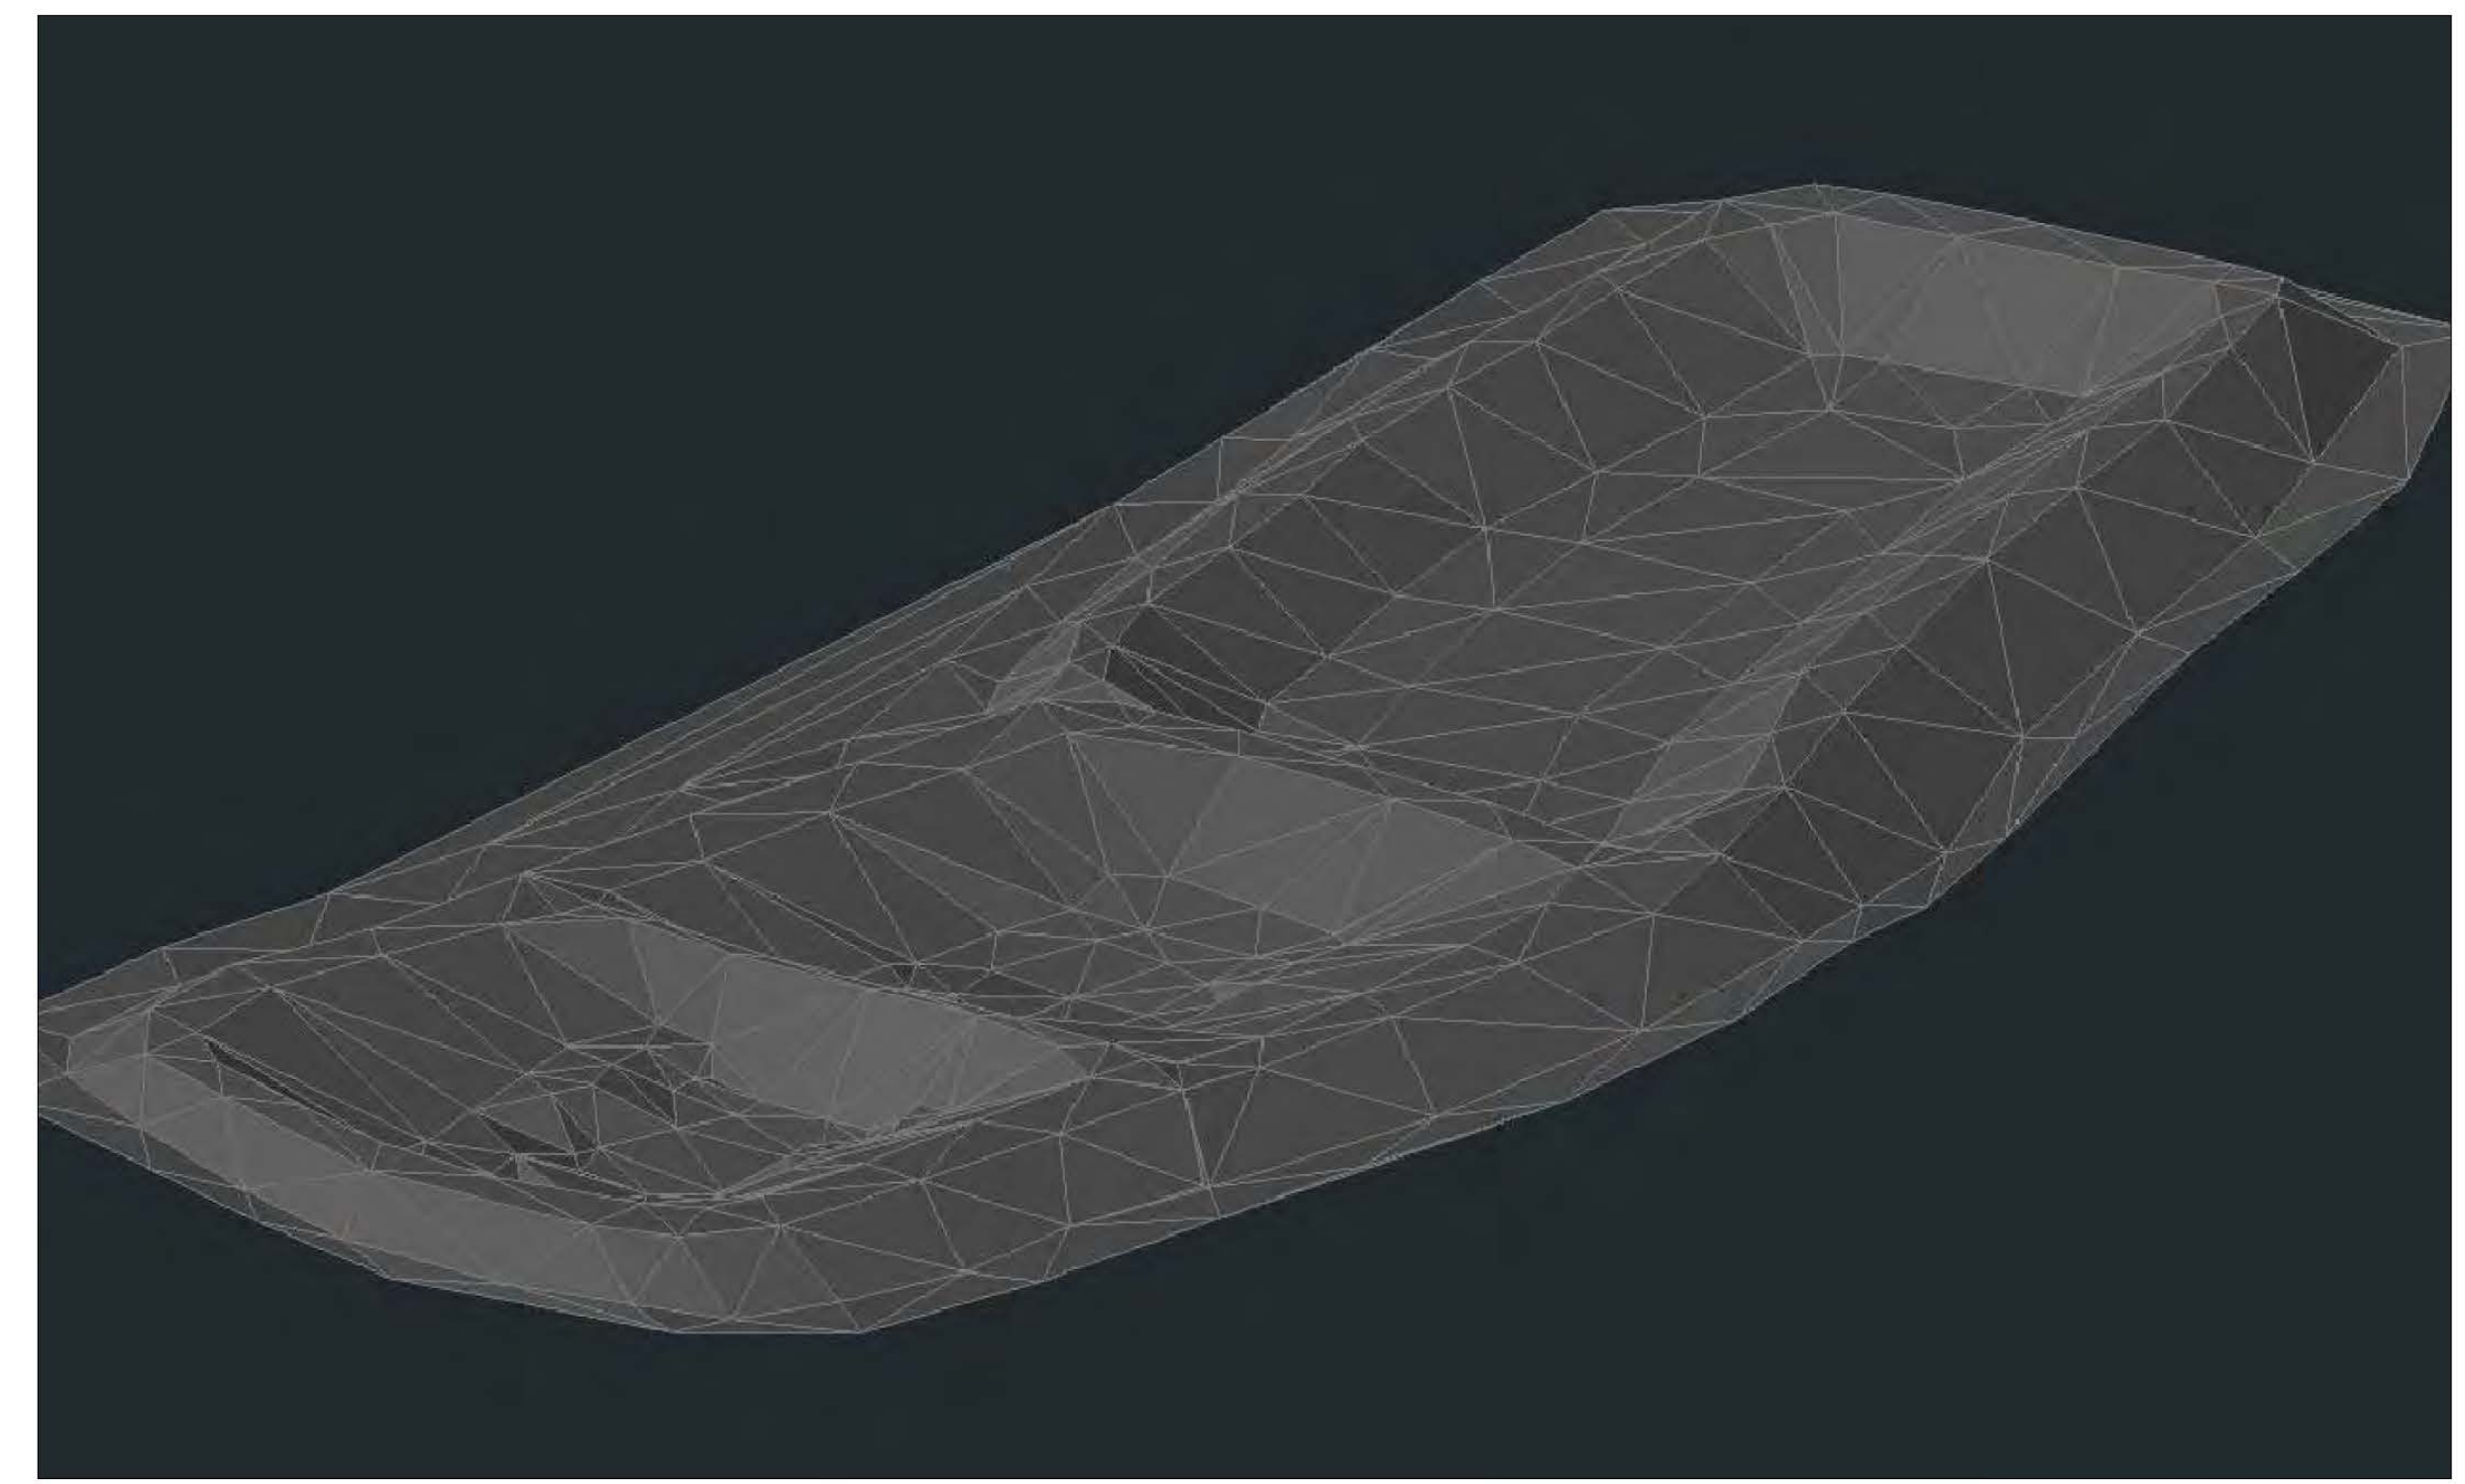


REV.	D/M/Y	REVISION	DR	CHK	APP	ISS	D/M/Y	APP	ISSUED FOR	REF	SUBJECT	DRAWING NUMBER
0	01/10/10								LOCATION PLAN			

PROPRIETARY INFORMATION:  
This drawing has been prepared for the use of AEL and TEES client and may not be used, reproduced or relied upon by third parties, except as agreed by AEL and TEES, and its client. AEL and TEES accepts no responsibility and denies any liability whatsoever to any party that modifies this drawing without express written consent by AEL and TEES.

STAMP/SEAL

APPROVED FOR CONSTRUCTION		
CLIENT PROJECT MGR.	ENGINEERING MGR.	R.E.J. PROJECT MGR.
PROJECT PHASE <b>TUNDRA MINE SITE REMEDIATION</b>		
PROJECT NO. 2010-03	ACTIVITY NO.	PACKAGE CODE
Scale N.T.S	dsn.	Date Jan. 30, 2012
	drn. jsb	

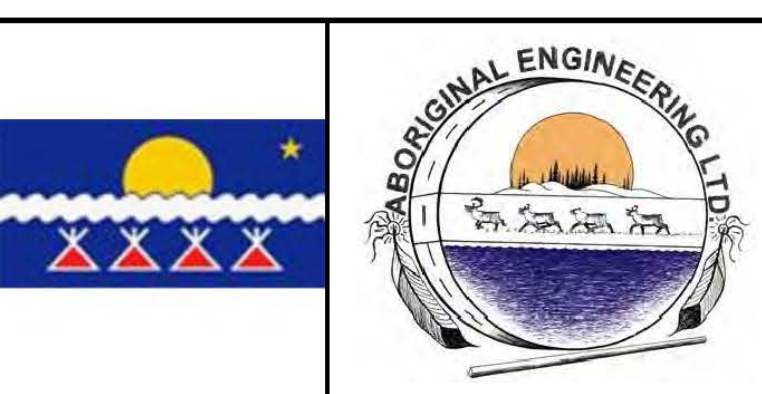

SITE REMEDIATION - TUNDRA MINE, NORTHWEST TERRITORIES	
SUBJECT <b>SEWAGE LAGOON AS-BUILT</b>	
DRAWING NO. 2010-03-100-01	REV. 0